


REVIEWED BY:	DATE:	REVIEWED BY:	DATE:
CONSTRUCTION	SURVEY	TRAFFIC	ENVIRONMENTAL
MAINTENANCE			
REAL ESTATE			

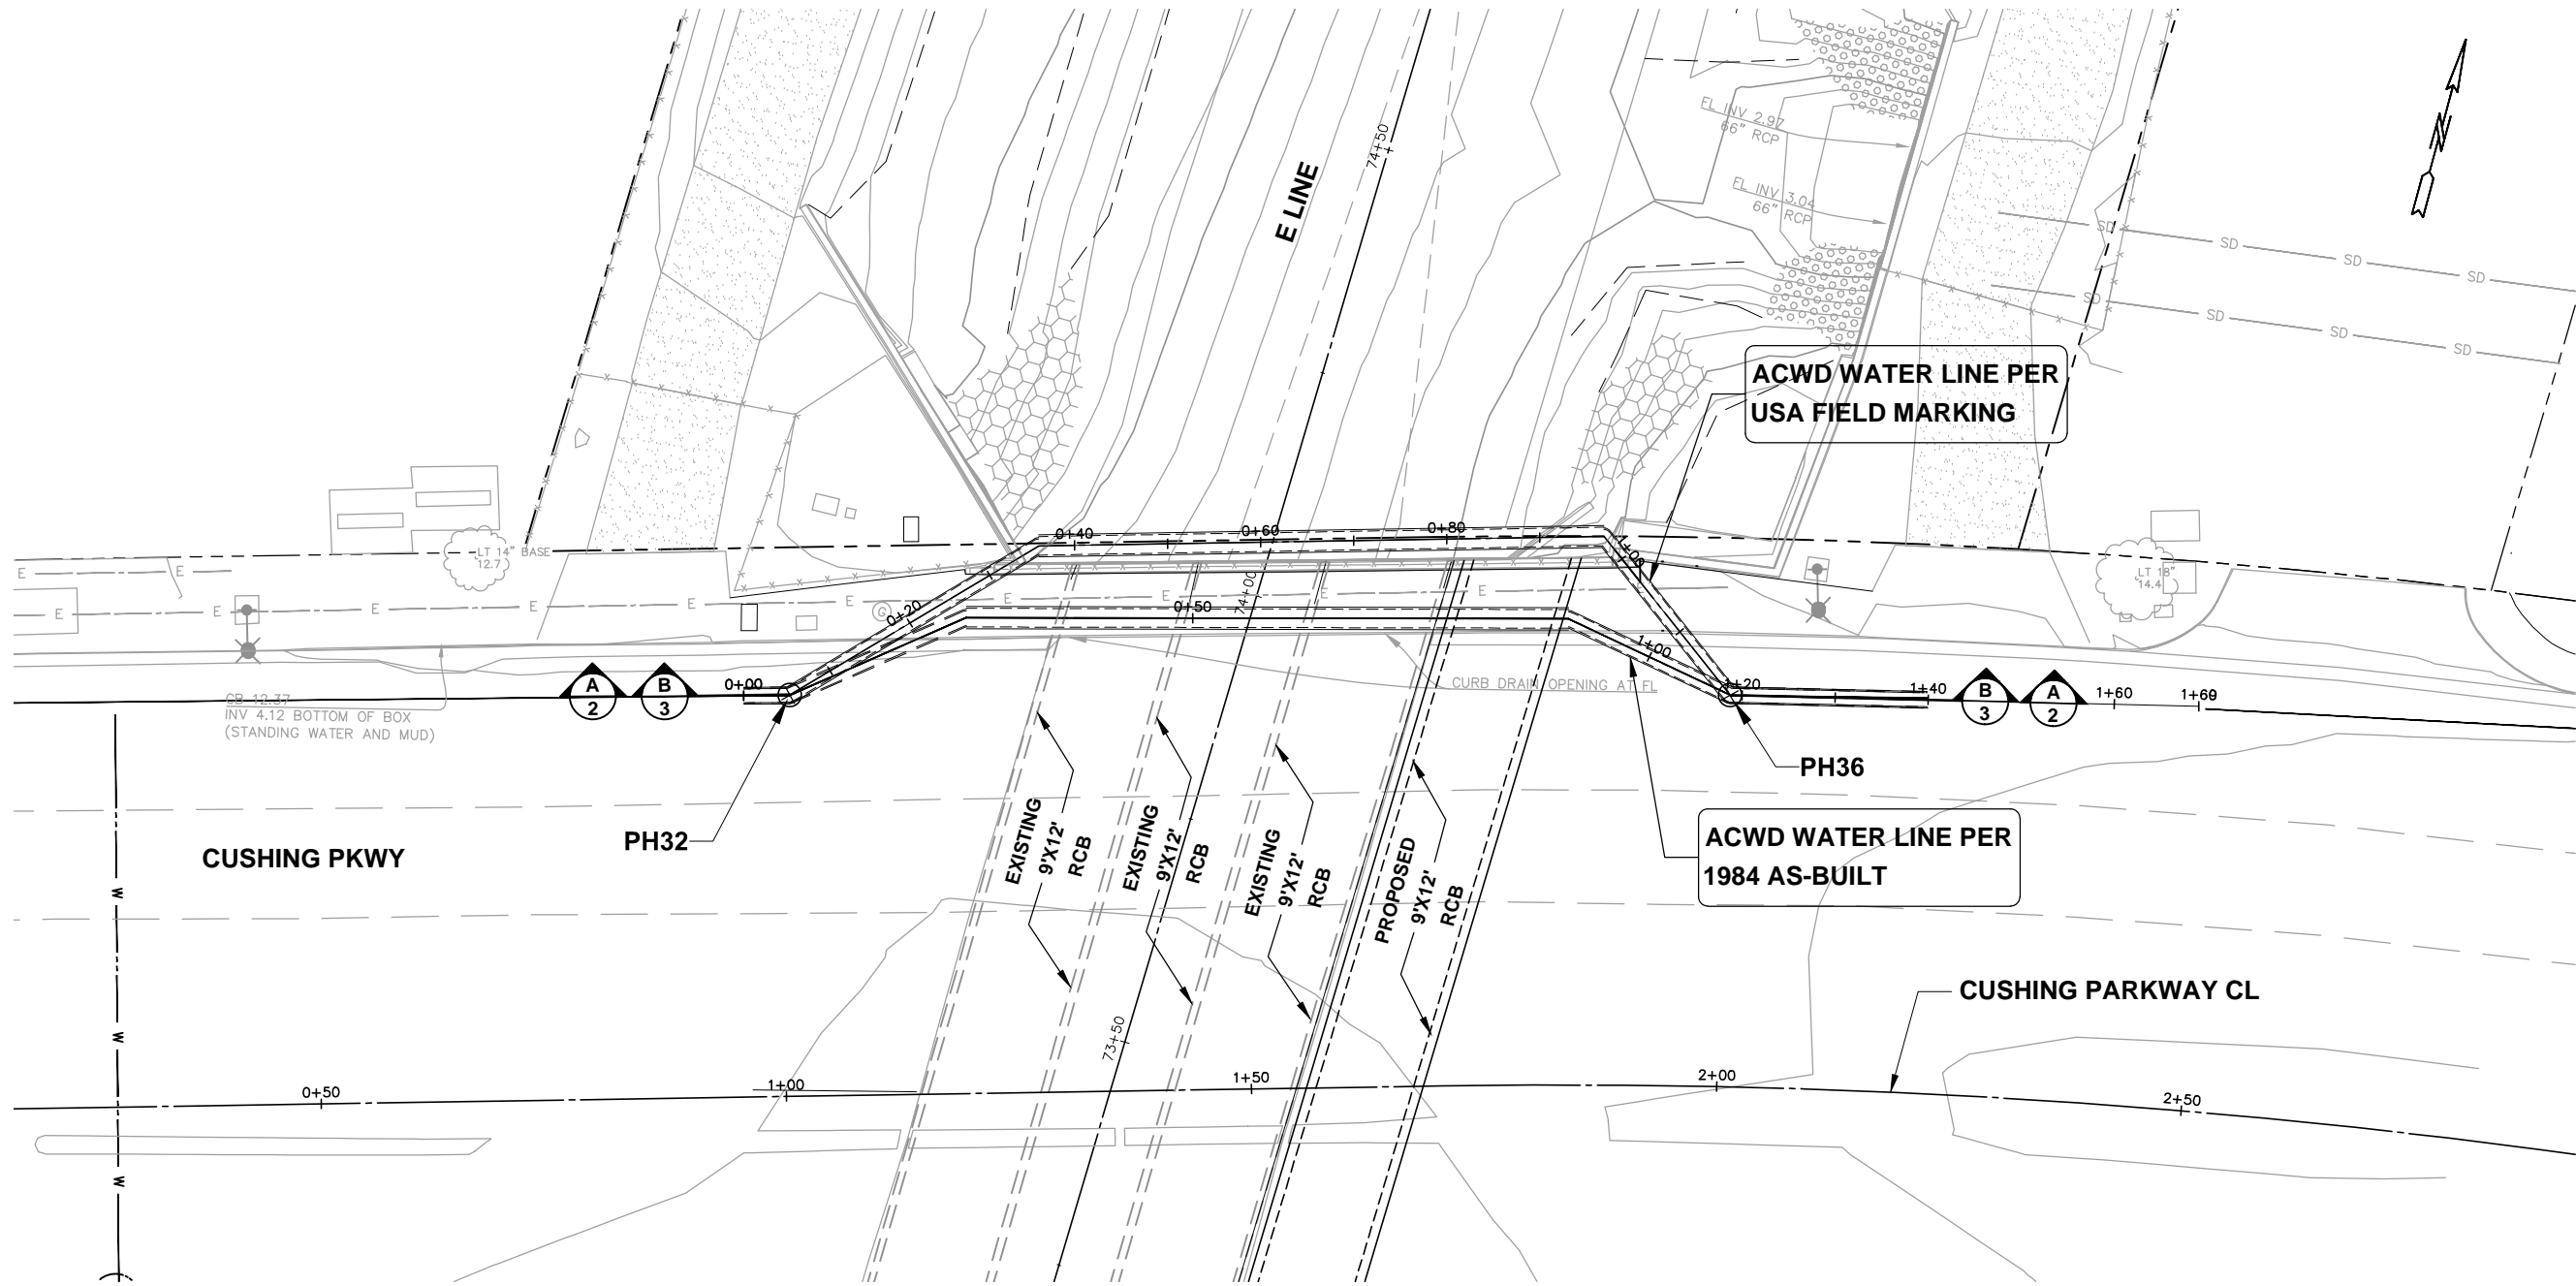

PLAN-ACWD USA FIELD MARKINGS VS. AS-BUILT PLANS (1984)

SCALE: 1"=10'

EXHIBIT 4

N:\CDD\1000\F06C81 - Cushing Culvert_Xing\Profile\Profile Plot-orig 4-30-14 03:41:33 PM benjamin

FOR REDUCED ENGLISH PLANS
ORIGINAL SCALE IS IN INCHES



REVISIONS


NO.	DESCRIPTION	BY	DATE	APPVD

COUNTY OF ALAMEDA PUBLIC WORKS AGENCY

ZONE NO. 6 PROJECT	APPROVAL RECOMMENDED	SCALE
ACWD WATER LINE	CHARLES JOSTUS	AS SHOWN
ALONG LAGUNA CREEK AT CUSHING PKWY	DESIGNED	DATE
	LESIUS ESPINOZA	ADV DATE
	CHECKED	
	LESIUS ESPINOZA	

WORK ORDER NO.	F06C81
SPECIFICATION NO.	FC ##-###
SHEET NO.	1 OF 3
FILE NO.	CB-###

CONSTRUCTION	REVIEWED BY:	DATE:	SURVEY	REVIEWED BY:	DATE:
MAINTENANCE			TRAFFIC		
REAL ESTATE			ENVIRONMENTAL		

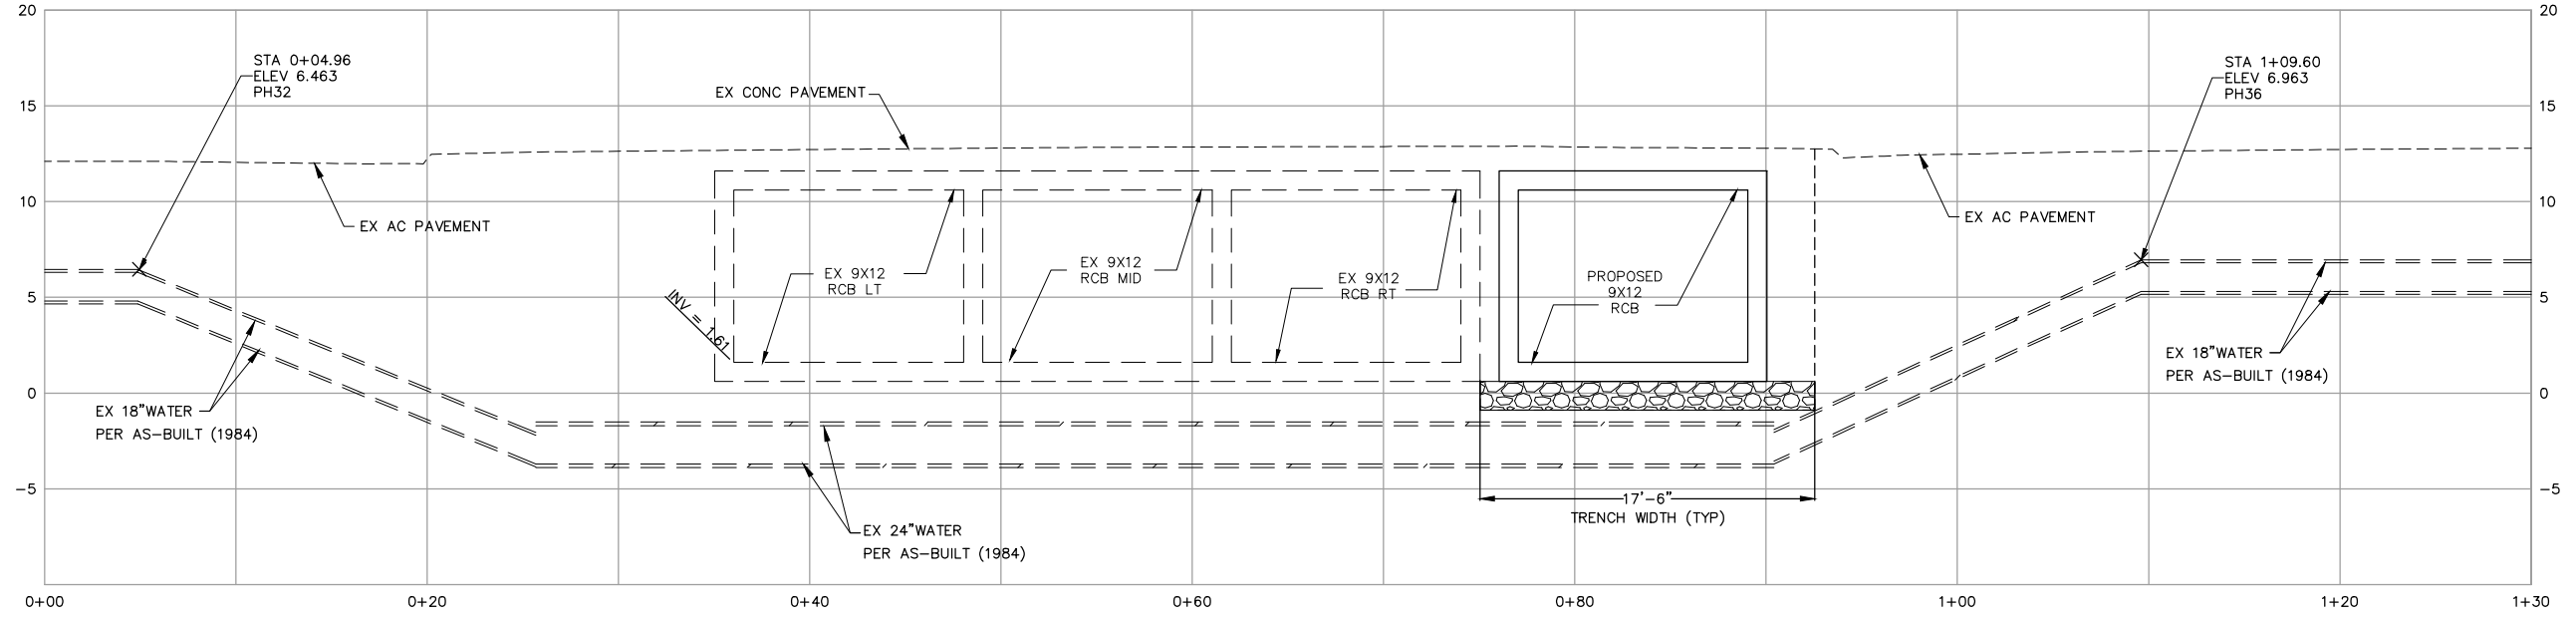

PROFILE B - PER 1984 AS-BUILT PLANS

SCALE: HORZ. 1"=5'
VERT. 1"=5'

N:\CD\VL000\F06C81 - Cushing Culvert.Xmg\Profile\Profile Point Plan-.dwg 4--16--14 09:36:50 AM benjaminhd

FOR REDUCED ENGLISH PLANS
ORIGINAL SCALE IS IN INCHES



REVISIONS

NO.	DESCRIPTION	BY	DATE	APPVD

COUNTY OF ALAMEDA ☆ **PUBLIC WORKS AGENCY**


ZONE NO. 6 PROJECT
ACWD WATER LINE
ALONG LAGUNA CREEK AT CUSHING PKWY
PLAN & PROFILE

APPROVAL RECOMMENDED
DESIGNED
CHECKED

CHARLES JOSTUS
JESUS ESPINOZA
JESUS ESPINOZA
DATE
ADV DATE
SCALE
AS SHOWN

WORK ORDER NO.
F06C81
SPECIFICATION NO.
FC ##-###
SHEET NO.
3 OF 3
FILE NO.
CB-###

CONSTRUCTION	REVIEWED BY:	DATE:
MAINTENANCE	SURVEY	TRAFFIC
REAL ESTATE	ENVIRONMENTAL	

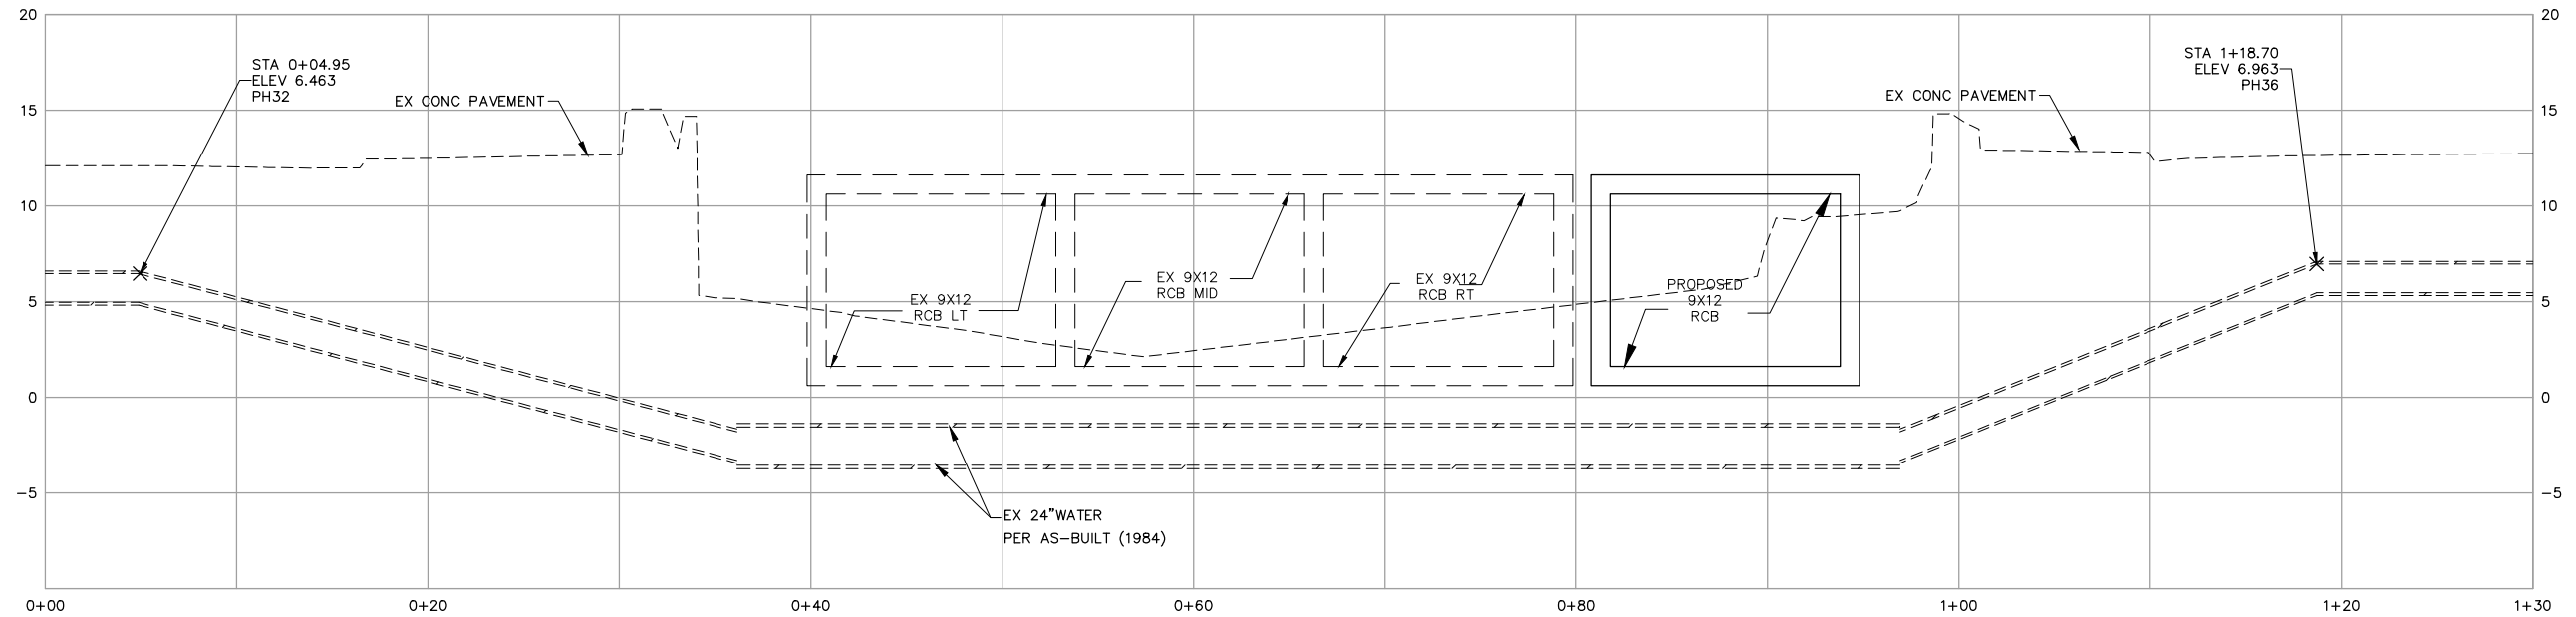

PROFILE A- PER USA FIELD MARKING

SCALE: HORZ. 1"=5'
VERT. 1"=5'

NOTE:

EXISTING AND PROPOSED RCB'S ARE SHOWN FOR REFERENCE ONLY, SINCE THEY ARE OUTSIDE OF THIS PROFILE LOCATION

N:\CDD\1000\F06C81 - Cushing Culvert_Xing\Profile\Profile Point_Plan-.dwg 4--16--14 09:35:34 AM benjaminhd

REVISIONS

NO.	DESCRIPTION	BY	DATE	APPVD

COUNTY OF ALAMEDA ☆ PUBLIC WORKS AGENCY

ZONE NO. 6 PROJECT
ACWD WATER LINE
ALONG LAGUNA CREEK AT CUSHING PKWY
PLAN & PROFILE

APPROVAL RECOMMENDED	APPROVED
CHARLES JOSTUS DESIGNED	MOSES TSIANG
JESUS ESPINOZA CHECKED	DATE ADV DATE AS SHOWN
JESUS ESPINOZA	SCALE AS SHOWN

WORK ORDER NO.	F06C81
SPECIFICATION NO.	FC ##-##
SHEET NO.	2 OF 3
FILE NO.	CB-###

FOR REDUCED ENGLISH PLANS
ORIGINAL SCALE IS IN INCHES

